

Tuesday, 18/03/2008 7:16:07 AM

User

Linda Lacelle

## **Process Sheet**

Customer

: CU-DAR001 Dart Helicopters Services

Type

S.O. No. :

Job Number **Estimate Number**  : 38070

P.O. Number

: 10193

This Issue

: 18/03/2008

: NC Prsht Rev.

First Issue : //

: 37723A **Previous Run** 

Written By

Checked & Approved By

Comment

: Rev Est:M 03.01.31

RF

Est Rev:N 06.04.05

Added level21

: LARGE FAB ASSY

Added D2012-117 for D130-701-041

EC

**Drawing Name** : 350/212/130 BASKET LID

Part Number

: D2512 · D2512 UNDER REVIEW

**Drawing Number Project Number** 

: N/A : D2

**Drawing Revision** Material

**Due Date** 

: 20/03/2008

Qty:

1 Um:

Each

**Additional Product** 

Job Number:



Seq. #:

**Machine Or Operation:** 

Description: 304 SQ Tube.75x.75x.065W

1.0

M304TS0750W065



Comment: Qty.:

45.7594 f(s)/Unit Total: 45.7594 f(s)

Pick:

3/4"x3/4" 304/316 SS tube .063" wall

Batch: M 107 315 V

2.0

D31663

Basket Hoop

1.0000 Each(s)



Pick:

1.0000 Each(s)/Unit Total:

Description

1 D3166-3

**Qty Part Number** 

**Basket Hoop** 

Batch B37612

Placard

PA 08.03.19

3.0

D2506

Comment: Qty.:

1.0000 Each(s)/Unit

Total:

1.0000 Each(s)

Pick:

**Qty Part Number** 1 D2506

Description

Label Plate

08.03.19

4.0

D23271

Spacer Bushing



Comment: Qty.:

2.0000 Each(s)/Unit Total:

Bushing

2.0000 Each(s)

Pick:

**Qty Part Number** 

2 D2327-1

Description

(08.03.19

## **Dart Aerospace Ltd**

Dait Ac	OSPACE											
W/O:			W	ORK ORDER CH	ANGES							
DATE	STEP	PROG	CEDURE CHA	NGE		Ву	Date	Date Qty Approval Chief Eng / Prod Mgr				
					<del></del>							
					olije							
Part No	:	PAR #:	_ Fault Cate	gory:	NC	R: Yes	No DQ	<b>A</b> :	_ Date: _			
						QA: N	I/C Close	d:	_ Date: _			
NCR:		W	ORK ORD	ER NON-CONFO	DRMANCI	E (NCF	₹)					
DATE	0750	Description of NC		<b>Corrective Action</b>	Section B		Verific	ation	Approval	Approval		
DATE	STEP	Section A	Initial Chief Eng	Action Descri	otion 	Sign 8	Secti		Chief Eng	QC Inspector		
					•							
					-							
		1										
6												

NOTE: Date & initial all entries

Date: Tuesday, 18/03/2008 7:16:07 AM User: Linda Lacelle **Process Sheet** Customer: CU-DAR001 Dart Helicopters Services Drawing Name: 350/212/130 BASKET LID Job Number: 38070 Part Number: D2512 Job Number: Seq. #: Description: **Machine Or Operation:** Hinge 5.0 D22321 Comment: Qtv.: 2.0000 Each(s)/Unit Total: 2.0000 Each(s) Pick: **Qty Part Number** Description 2 D2232-1 Hinge plate 6.0 D2581 Mounting Bracket Comment: Qty.: 2.0000 Each(s)/Unit Total: 2.0000 Each(s) Pick: **Qty Part Number** Description 2 D2581 Mounting Bracket 7.0 M304EX07516F Expanded Metal Flat Stai Comment: Qty.: 18.0000 sf(s)/Unit Total: Pick: **Qty Part Number** Description Batch 18 sf M304EX0.75-16F Expanded Metal 107/0736 LARGE FABRICATION RESOURCE 1 8.0 LARGE FAB 1 Comment: LARGE FABRICATION RESOURCE 1 1-Cut 3/4" x 3/4" square tubing as per Dwg D2512 2-Cut (4) D2236 From D3166-3

3-Drill holes in D2512-1 as per Dwg D2512 using Drill Jig DT8305

5-Weld as per Dwg D2512 using Welding Table and corner Jig Deburr as required VISUAL WELDING INSPECTION

QC9

Comment: VISUAL WELDING INSPECTION



9.0

Dart Ae	rospace	e Ltd								
W/O:			W	ORK ORDER CH	ANGES					
DATE	STEP	PRO	CEDURE CHA	NGE		Ву	Date	Qty	Approval Chief Eng / Prod Mgr	Approval QC Inspector
							Annual State Control of the Control of the second			
		PAR #:				QA: N	C Close	. (	Date: <u></u>	भा <i>03/9</i> 0
NCR:		V		ER NON-CONFO	RIVIANCE	: (NCR	) 		·	
DATE	STEP	Description of NC Section A	Initial Chief Eng	Corrective Action  Action Descrip  Chief Eng	Section B	Sign & Date	Verific Sect	cation ion C	Approval Chief Eng	Approval QC Inspector
			Office Ling	Cilier Eng		Date	,			

NOTE: Date & initial all entries

Date: Tuesday, 18/03/2008 7:16:07 AM User: Linda Lacelle **Process Sheet** Customer: CU-DAR001 Dart Helicopters Services Drawing Name: 350/212/130 BASKET LID Job Number: 38070 Part Number: D2512 Job Number: Seq. #: **Machine Or Operation:** Description: 10.0 QC6 DIMENSIONAL CHECK Comment: DIMENSIONAL CHECK a 11.0 POWDER COATING Comment: POWDER COATING Powder Coat White Gloss (Ref: 4.3.5.1) as per QSI 005 4.3 12.0 HAND FINISHING RESOURCE #1 Fot 08/03/20 HAND FINISHING RESOURCE #1 Spray Powing Walk and Spray Paint black as per Dwg D2512 and QSI 005 4.4 6. Comment: HAND FINISHING RESOURCE #1 13.0 QC3 POWDER COAT/CHEMICAL CONVERSION Comment: INSPECT POWDER COAT/CHEMICAL COMMERSION 14.0 PACKAGING 1 PACKAGING RESOURCE #1 Comment: PACKAGING RESOURCE #1 Identify and Stock Location 15.0 QC21 Comment: FINAL IN PECTION/W/O RELEASE 404.63.20 Job Completion

## **Dart Aerospace Ltd**

W/O:			<u>.</u>	VORK ORDER CHANG	ES		<u> </u>		<del></del>	
DATE	STEP	PROC	EDURE CI			Ву	Date	Qty	Approval Chief Eng / Prod Mgr	Approval QC Inspector
				- 4						4
			is i							
		,					2.			
Part No		PAR #:	_ Fault Ca	tegory:	NCI	R: Yes N	lo <b>DQA</b> :		Date:	
			+ *	4. 81 - 64		QA: N/C	Closed:		_ Date: _	
NCR:		W	ORK OR	DER NON-CONFORMA	NCE	(NCR)				
		Description of NC		Corrective Action Section	on B		Verificat	ion	Approval	Approval
DATE	STEP	Section A	Initial Chief Eng	Action Description Chief Eng		Sign & Date	Section		Chief Eng	QC Inspector
								•		
			ţ.							
										3>

NOTE: Date & initial all entries






	DESIG	BW	CRAWN BY	DART AEROSPACE LTD HAWKESBURY, ONTARIO, CANADA
į	CHECK	(ED )	APPROVED	DRAWING NO. REV. D
Ī		A	eff	D2512 SHEET 1 OF 4
	DATE	40	· - 1	TITLE SCALE
	01.0	)4.19		BASKET LID ASSEMBLY (350/212) NTS
	Α		95.11.21	NEW ISSUE
	В		96.05.24	ADDED LATCH CHANNEL & LABEL PLATE
	С		99.07.06	REMOVE DOUBLE SKIN SECTION, ADDED MEMBERS, INCORP. DEO 9074
	D		01.04.19	CHANGE HINGE
	DI	4 1	03 01. 20	ADD D2012-117 FOR D130-701-041

THE E WELD ONE SHOW OREA

D2 18-if in 11 1 PARTS LIST FOR D2512 BASKET LID ASSEMBLY

				,
PART NO	QUANTITY	LENGTH	LENGTH	DESCRIPTION
		Α	В	
D2512-1	2		25.50	RIB
D2512-3	2		95.30	RIB
D2512-5	6	30.84		RIB
D2512-7	3	30.63		RIB
D2232-1	2	N/A	N/A	HINGE PLATE
D2236	4	N/A	N/A	RIB
D2327-1	2	N/A	N/A	BUSHING
D2506	1	N/A	N/A	LABEL PLATE
D2581	2	N/A	N/A	MOUNTING BRKT

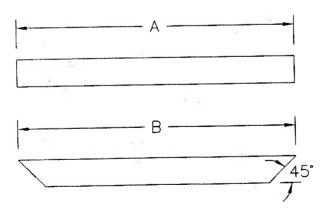


TUBING TO BE CHANGED TO U.OFS

D2512-1/-3/-5/-7


CUT LENGTH/SHAPE PER DIAGRAM AND PARTS LIST MATERIAL: AISI 304/316 SS, 3/4 X 3/4 X 0.060 WALL SQUARE TUBING TOLERANCES ARE PER DART QSI 018 UNLESS OTHERWISE NOTED ALL DIMENSIONS ARE IN INCHES

Copyright © 1995 by DART AEROSPACE LTD

THIS DOCUMENT IS PRIVATE AND CONFIDENTIAL AND IS SUPPLIED ON THE EXPRESS CONDITION THAT IT IS NOT TO BE USED FOR ANY PURPOSE OR COPIED OR COMMUNICATED TO ANY OTHER PERSON WITHOUT WRITTEN PERMISSION FROM DART AEROSPACE LTD.

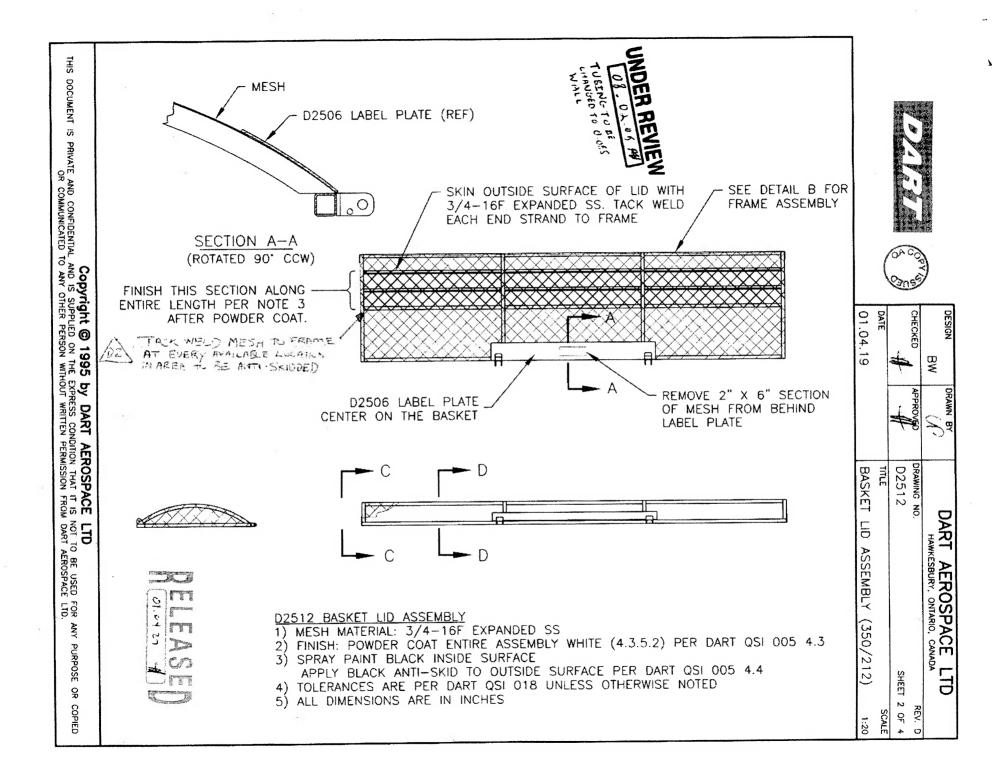


	and the same	PIN TEL PROPERTY PROP			,				
		12							
<b>F</b>			14	1.5	 9	100			
•		¥.							
									1
									100
7 7 5		5							- Same
: :									
							- 4.0		
			*						1 -4
en de									1
- Control of the Cont									
					4				
·  3 ·					6				
					4				
9									
У									
	. +							7	
e]' 								;	
					a)				
A CONTRACTOR OF THE CONTRACTOR			*						
and of the state o				364	4				
€									į
8-			19					1	,
									-
								7	
								Ĭ.	•
								25	
±a abu	Mining	id flater our der e						1	

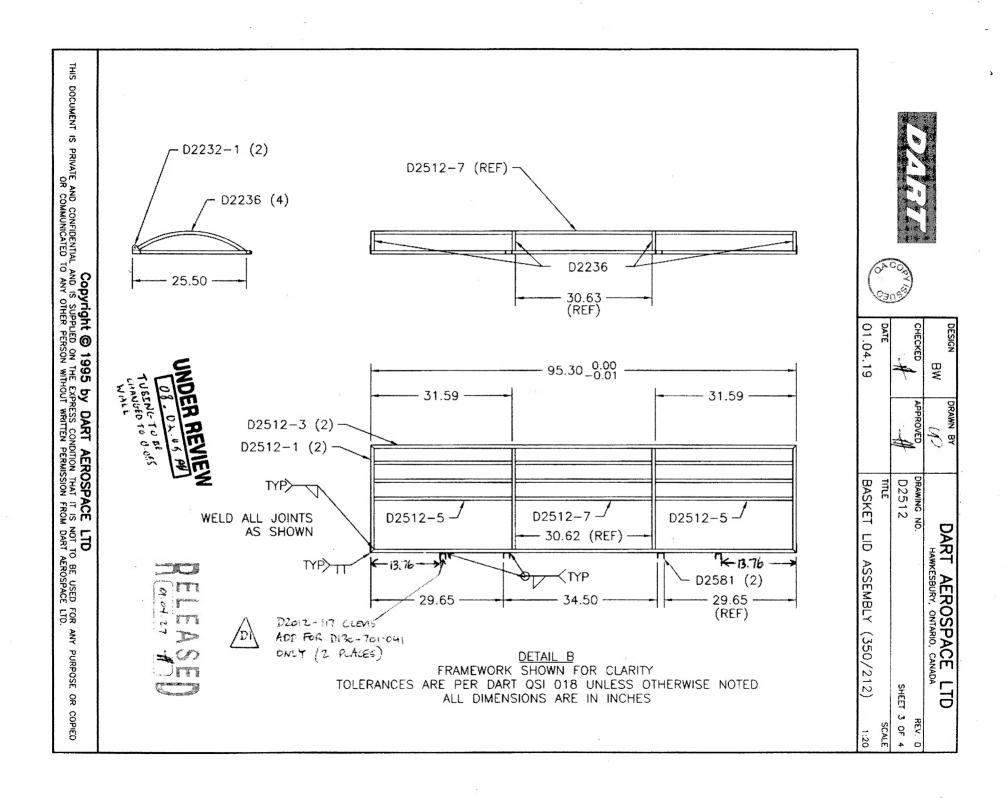








DESIGN BW	DRAWN BY	DART AEROSPACE LTD HAWKESBURY, ONTARIO, CANADA	
CHECKED	APPROVED	DRAWING NO. D2512 SHEET	REV. D
DATE		TITLE	SCALE
01.04.19		BASKET LID ASSEMBLY (350/212)	1:8

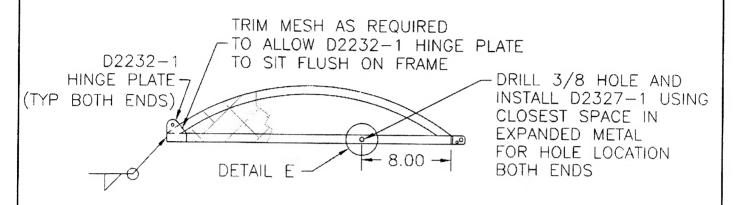


## SECTION C-C SIMILIAR BOTH END RIBS

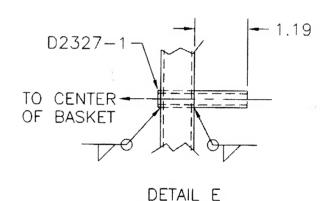

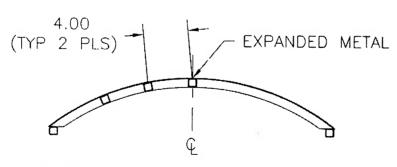

 



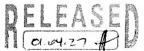

Copyright © 1995 by DART AEROSPACE LTD

THIS DOCUMENT IS PRIVATE AND CONFIDENTIAL AND IS SUPPLIED ON THE EXPRESS CONDITION THAT IT IS NOT TO BE USED FOR ANY PURPOSE OR COPIED OR COMMUNICATED TO ANY OTHER PERSON WITHOUT WRITTEN PERMISSION FROM DART AEROSPACE LTD.